


Temporary Hospital Buildout and Design: Floorplans

Mercy Hospital Joplin

2018

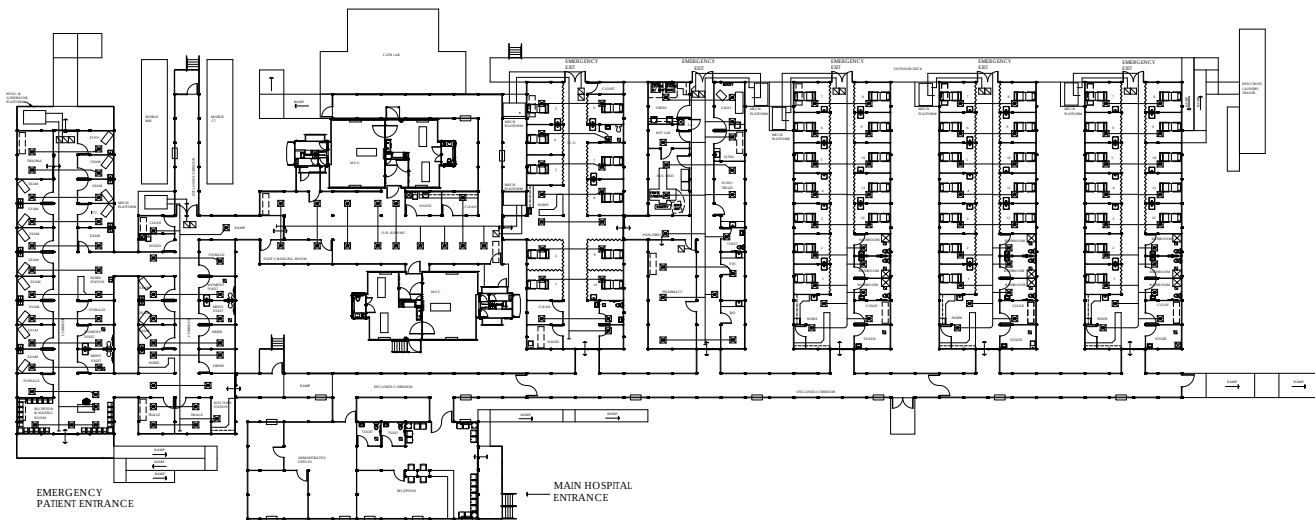


OVERALL HVAC PLAN



Floor No.
1ST FLOOR
Sheet No.
M1.0

Building Name
St. John's Mercy Health Care
123 S Main St.
Project Name & Project Number
SERENUS JOHNSON PORTABLES
As-Built
Date
01-05-2012
Scale
1/16"=1'-0"


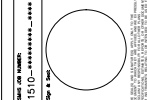


PROGRESS SET
NOT FOR CONSTRUCTION

No.	DATE	REVISIONS
1		
2		
3		
4		
5		
6		

Author: J. Johnson
1510-REVISIONS-4444



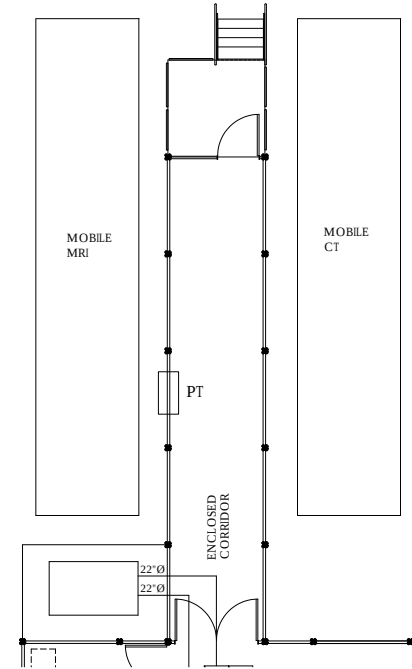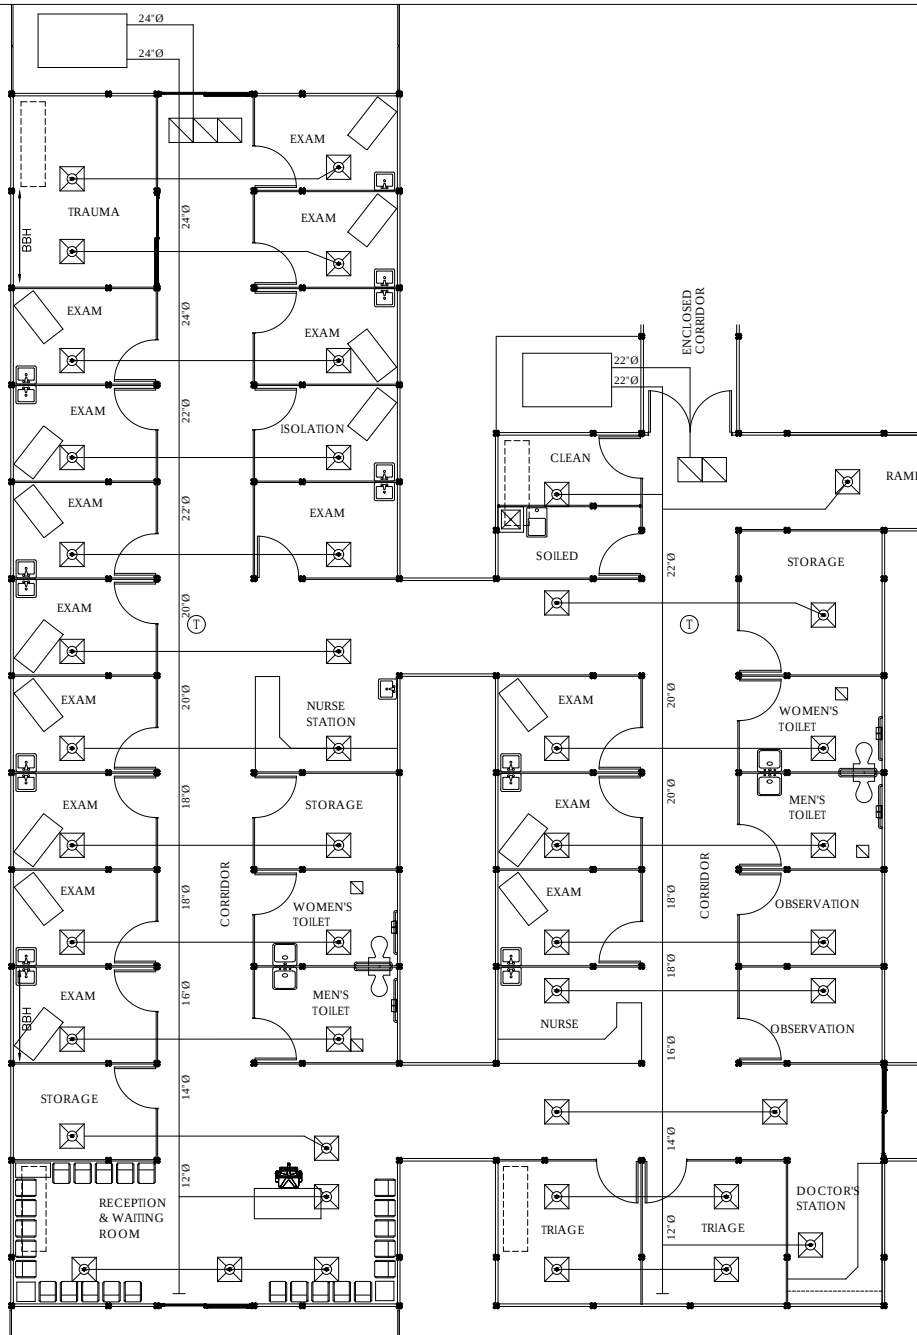


HVAC SPECIFICATIONS		
		MAX AMP
1 EMERGENCY PATIENT	10 TON, 27 KW	91.50000
1 EMERGENCY PATIENT	7.5 TON, 18 KW	62
O.R. SUPPORT	6 TON, 18 KW	58.60000
1 I.C.U.	8.5 TON, 18 KW	64.00000
1 NURSE	6 TON, 18 KW	58.60000
COMBINATION PHARMACY	7	62
3 PATIENT WINGS	8.5 TON, 18 KW	62
		62
TOTAL		463.50000

EMERGENCY DEPARTMENT HVAC PLAN



No.	DATE	REVISIONS
1		
2		
3		
4		
5		
6		


PROGRESS SET
NOT FOR CONSTRUCTION

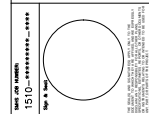

St. John's Mercy Health Care
123 s Main St.
Project Name & Project Number
SERENUS JOHNSON PORTABLES
Date: 01-05-2012
Scale: 1/4"=1'-0"

Mercy

1ST FLOOR
M1.2

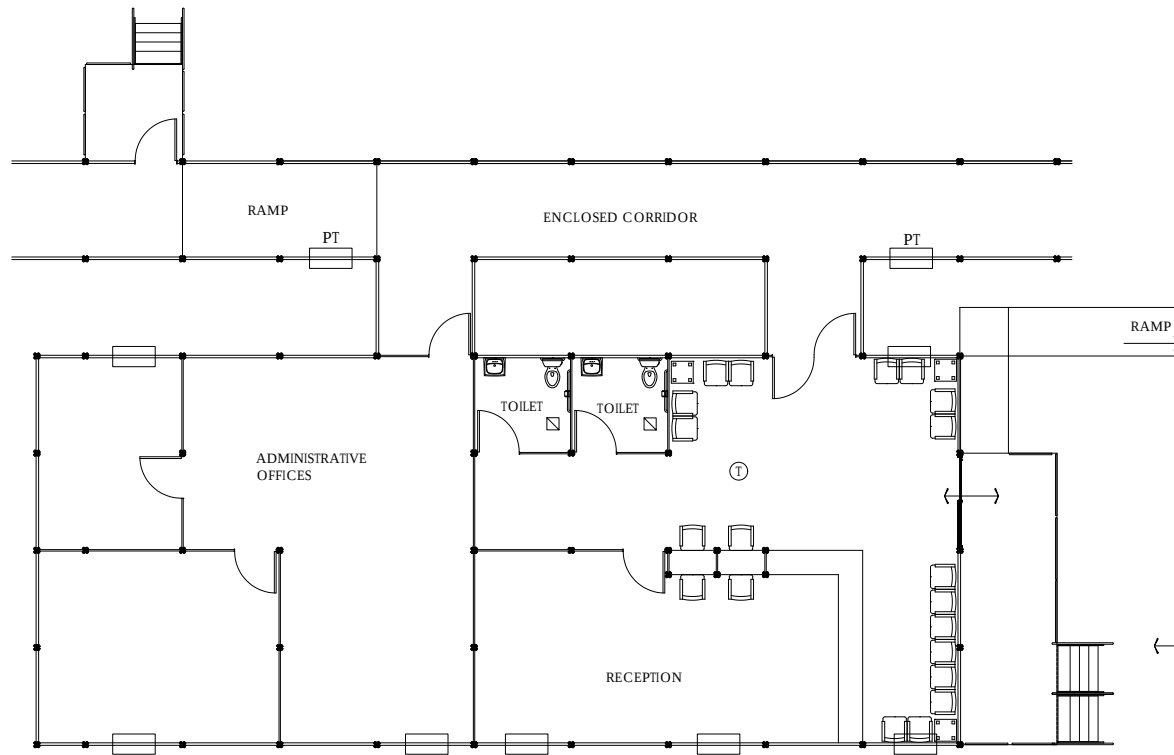

ADMINISTRATION HVAC PLAN

HVAC SPECIFICATIONS		
		MAX. AMP
1 EMERGENCY PATIENT	10 TON, 27 KW	91.30000
1 EMERGENCY PATIENT	7.5 TON, 18 KW	62
0 R. SUPPORT	6 TON, 18 KW	58.00000
1 I.C.U.	8.5 TON, 18 KW	64.00000
1 X-RAY	6 TON, 18 KW	58.00000
1 COMPUTING PHARMACY	7	
3 PATIENT WINGS	8.5 TON, 18 KW	62
		62
TOTAL		463.50000



No.	DATE	REVISIONS
1		
2		
3		
4		
5		
6		

PROGRESS SET
NOT FOR CONSTRUCTION



St. John's Mercy Health Care
123 S Main St.
SERENUS JOHNSON PORTABLES
As-Built
01-05-2012
1/4"=1'-0"



1ST FLOOR
M1.3




1ST FLOOR
Sheet No. M1.6

Building Name
St. John's Mercy Health Care
123 s Main St.

Project Name & Project Number

As-Built

PROGRESS SET
NOT FOR CONSTRUCTION

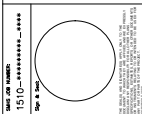

No.	DATE	REVISIONS
1		
2		
3		
4		
5		
6		

Architects or Designers or Engineers Logoff



Serenus Johnson